AS-BUILT, Index # 24847

COPYRIGHT © 2010 SWA

LEGEND

P-1	CONCRETE PAVING, PEDESTRIAN
P-3	EXPOSED AGGREGATE
P-4B	PERVIOUS CONCRETE, PEDESTRIAN
P-5	CONCRETE BAND
P-6	DECOMPOSED GRANITE
P-10	SCORE JOINT
P-11	EXPANSION JOINT
SA-1	METAL HEADER
SA-5A	STEEL BOLLARD
SA-5B	REMOVABLE BOLLARD
SF-3	BIKE RACK, SINGLE-SIDED
L-1	PROPOSED CAMPUS SHOEBOX LIGHT
	EXISTING LIGHT TO REMAIN
PA	PLANTING AREA
	EXISTING TREE

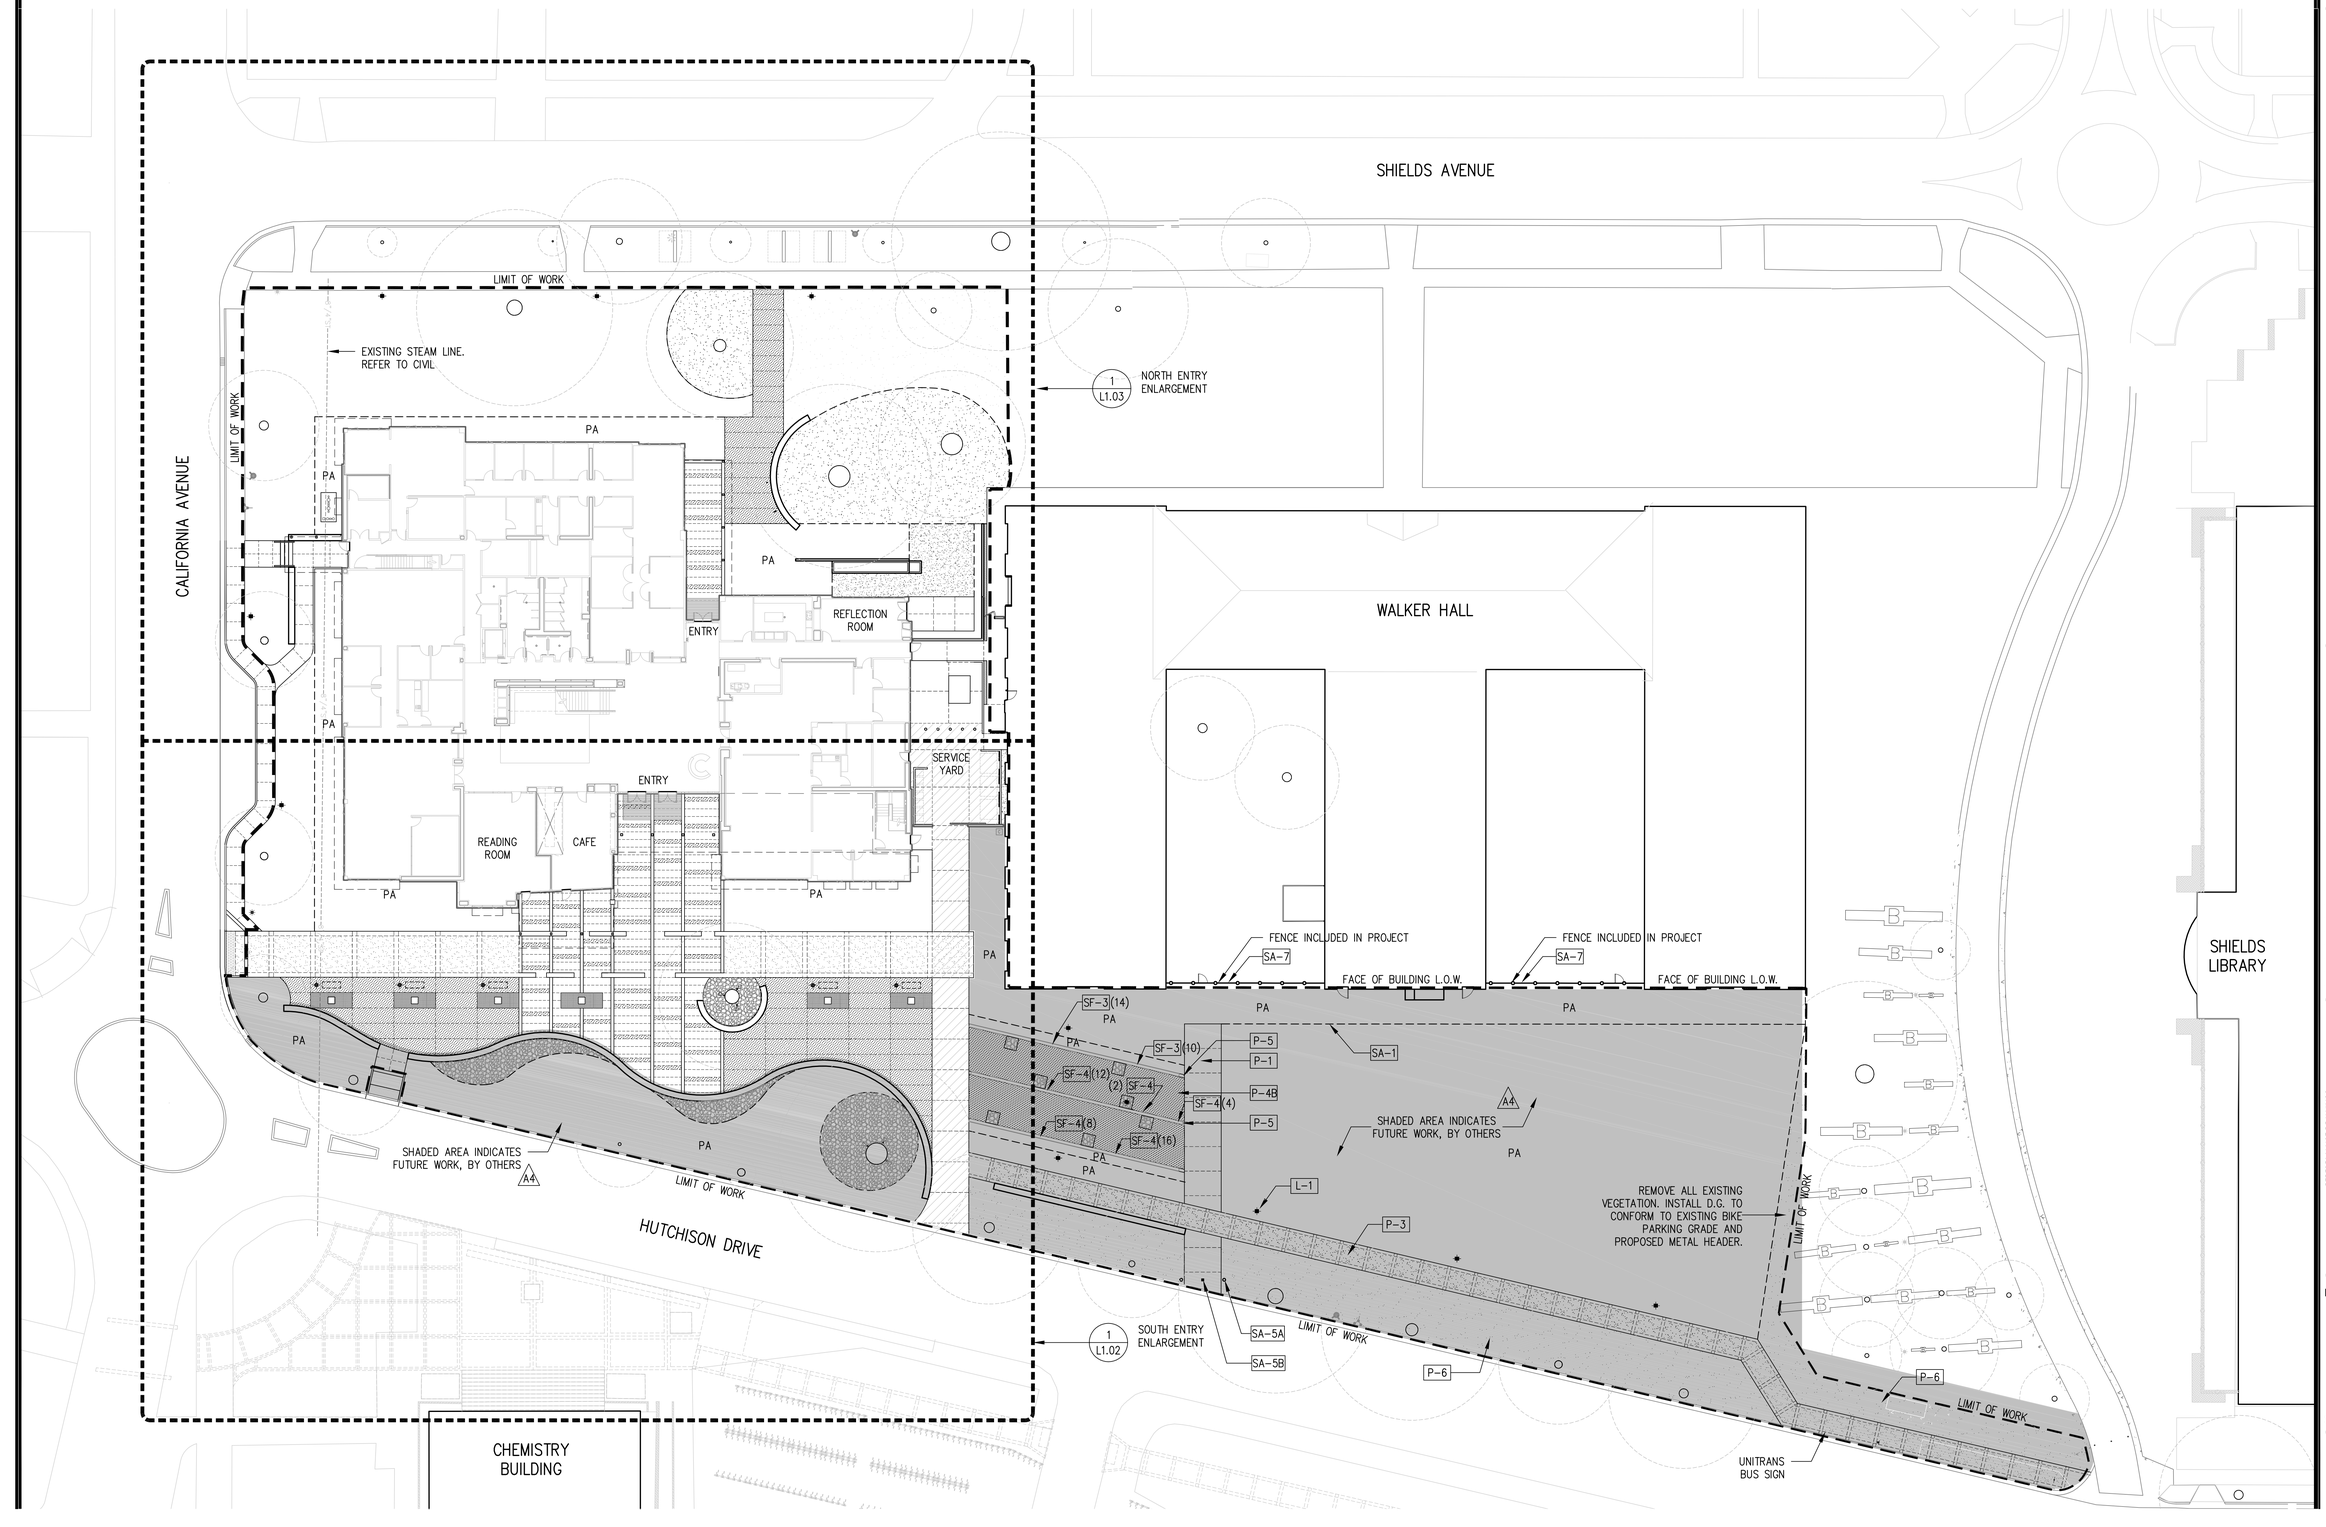

SWA
Sausalito
Laguna Beach
Houston
Dallas
San Francisco
2200 Bridgeway Boulevard
P O Box 5904, Sausalito
CA 94966.5904
Fax 415.332.0719
Ph 415.332.5100
www.swagroup.com

UC DAVIS STUDENT COMMUNITY CENTER

UCD PROJECT #9512900

DRAWN BY
CHECKED BY
PROJECT NO BARN901

DATE	ISSUE
10.15.09	DESIGN BUILD BID SET
01.26.10	ADDENDUM A4

PERFORMANCE DRAWINGS

ALL INFORMATION CONTAINED OR IMPLIED IN THESE DOCUMENTS REPRESENTS THE UNIVERSITY'S DESIGN INTENT FOR THE BASIC LAYOUT AND AESTHETICS AND IS PROVIDED FOR INFORMATIONAL PURPOSES ONLY. NO REPRESENTATIONS OR WARRANTIES, EXPRESSED OR IMPLIED ARE MADE REGARDING THE COMPLETENESS OF THE INFORMATION, OR COMPLIANCE WITH ANY APPLICABLE CODES, REGULATIONS, ORDINANCES OR LAWS. DIMENSIONS SHOWN IN THE DRAWINGS MAY NOT BE TO SCALE. DESIGN BUILDER IS SOLELY RESPONSIBLE FOR THE CONSTRUCTION DOCUMENTS, WHICH ARE TO BE PREPARED BASED ON THESE PERFORMANCE DRAWINGS.

LAYOUT PLAN

SCALE: 1"=20'-0"

North

L1.01